



2  
D.P.33700

AMENDMENTS:		
AMENDMENT	DATE	DESCRIPTION

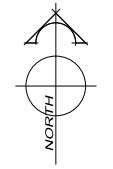

**SERVICES:**

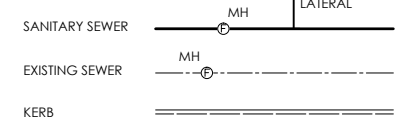

**NOTES:**

1. LOCATION OF LATERALS PROVIDED BY TEXCO GROUP.
  2. ALL LATERALS ARE LAID AT 1:60 MINIMUM GRADE.
  3. ALL LATERALS ARE Ø100mm uPVC.
  4. LEVELS IN TERMS OF MEAN SEA LEVEL LYTTELTON DATUM 1937.
- ORIGIN OF LEVELS : SS11A SO 797 RL=9.42.  
LEVELS PRE 2010 & 2011 CANTERBURY EARTHQUAKES.



**DAVIE LOVELL-SMITH**  
PLANNING SURVEYING ENGINEERING

116 Wrights Road P O Box 679 Christchurch 8140. New Zealand  
Telephone: 03 379-0793 Fax: 03 379-5664 E-mail: office@dls.co.nz

JOB TITLE:  
**Fulton Hogan Ltd.  
Rosemeryn Farm Stage 5  
RC. 135001**

SHEET TITLE:  
**Sewer Asbuilt**

DRAWING STATUS:  
**Asbuilt**

SCALE: 1:500@A1 DATE: July 2014  
1:1000@A3

CAD FILE: J:\18316.ASBUILT\18316.AB01.NZM.dwg REVISION:  
DRAWING No: SHEET No:  
**E18316.AB.SS01.0** **RO**

1  
DP 33662

3  
DP 50540


1  
DP 57260






AMENDMENT	DATE	DESCRIPTION

NOTES:

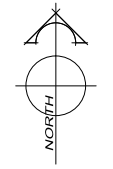

SERVICES:

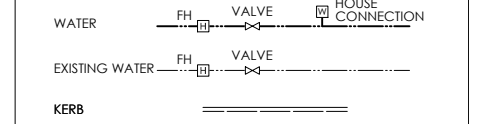

NOTES:

1. LOCATION OF SUBMAINS AND WATERMAINS PROVIDED BY TEXCO GROUP.
2. ALL SUBMAINS ARE Ø63mm (OD) PE BLUELINE PN12.5 WITH ASSOCIATED FITTINGS.
3. ALL HOUSE CONNECTIONS ARE 25mm POLY AND INCLUDE GATE VALVE, TOBY BOX, TAPPING BAND & FERRALE.
4. ALL MAINS ARE CLASS D uPVC OR SIMILAR APPROVED.
5. ALL WATER LATERALS ARE Ø25mm PE 'BLUELINE' PN12.5 WITH ASSOCIATED FITTINGS.



**DAVIE LOVELL-SMITH**  
 PLANNING SURVEYING ENGINEERING

116 Wrights Road P O Box 679 Christchurch 8140, New Zealand  
 Telephone: 03 379-0793 Fax: 03 379-5664 E-mail: office@dls.co.nz

JOB TITLE:  
**Fulton Hogan Ltd.  
 Rosemerryn - Lincoln  
 Stage 5**

SHEET TITLE:  
**Water Asbuilt**

DRAWING STATUS:  
**Asbuilt**

SCALE: 1:500@A1  
 1:1000@A3 DATE: July 2014

CAD FILE: J:\18316.ASBUILT\18316 AB01 NZTM.dwg REVISION:  
 DRAWING No: SHEET No: 1 of 1  
**E18316.AB.W01.0**

1 DP 33662

3 DP 50540

1 DP 57260

2 DP 14543

1 DP 35115

1 DP 65371

22

18